

June 9, 2016

Melanie Bachman  
Acting Executive Director  
Connecticut Siting Council  
10 Franklin Square  
New Britain, CT 06051

Re: **EM-VER-108-150429 – Cellco Partnership d/b/a Verizon Wireless  
338 Oxford Road, Oxford, Connecticut**

Dear Ms. Bachman:

On May 18, 2015, the Siting Council acknowledged receipt of Cellco's notice of intent to modify its telecommunications facility at 338 Oxford Road in Oxford, Connecticut. The modifications involved the replacement of its antennas, the installation of remote radio heads and the installation of a new fiber optic antenna cable.

As required by the Council's approval, attached is a Tower Modification Certification letter confirming that some, but not all, of the approved equipment modifications referenced in the EM-VER-108-150429 Structural Report were completed. Cellco does not intend to complete the remaining approved modifications.

The Attached Professional Engineer's Tower Modification Certification letter also confirms that the tower will not exceed 100% of the post-construction structural rating for those Cellco modifications completed. The attached As-Built Equipment Configuration plan will serve as the baseline for all future Cellco facility modifications for its 338 Oxford Road cell site.

# Robinson+Cole

Melanie A. Bachman  
June 9, 2016  
Page 2

Please do not hesitate to contact me if you have any questions.

Sincerely,

A handwritten signature in black ink, appearing to read "Kenneth C. Baldwin". The signature is fluid and cursive, with a long horizontal stroke at the end.

Kenneth C. Baldwin

Attachment

Copy to:

Tim Parks  
Carlo F. Centore, PE

June 7, 2016

**Mr. Tim Parks**

Verizon Wireless  
99 East River Drive  
East Hartford, Connecticut 06108

**Re: Tower Modification Certification**

**Project:** Verizon Oxford  
338 Oxford Road, Oxford, CT

**Tower Owner:** Crown Castle USA  
220 Lathrop Road, Candor, NY

**Engineer:** Paul J. Ford and Company  
250 East Broad Street, Columbus, OH

**Centek Project No.:** 16003.07

**CSC Exempt Mod Reference No.:** EM-VER-108-150429

Dear Mr. Parks,

We are providing this "Tower Modification Certification" with regard to the structural components at the above referenced project.

The following are the basis for substantiating compliance with the tower modification documents prepared by Paul J. Ford and Company (PJF Project Number: 37515-0074.003.7700):

- Review of the Paul J. Ford and Company Structural Analysis dated 04/09/15.
- Review of the Paul J. Ford and Company Modification Drawings dated 04/09/15.
- Review of the Sinnott Gering and Schmitt Towers, Inc. Modification Inspection Report dated 2/26/16.
- Field observations by Centek Engineering personnel on 05/05/16 of the completed modifications which determined all modifications were installed in general compliance with the recommendations of the structural analysis report prepared by Paul J. Ford and Company on 04/09/15.


**Note:** Not all proposed equipment listed in the aforementioned Structural Analysis Report was installed. Refer to the As-Built Equipment Sketch (attached) dated 06/07/16. Less equipment was installed than included in the Structural Analysis Report; therefore the tower will not exceed 100 percent of the post construction structural rating. The work under this Contract has been reviewed and found, to the Engineer's best knowledge, information and belief, to be completed in general compliance with the documents referenced above. This certification is not a review of the adequacy or effectiveness of the modification/reinforcement solution.

Sincerely,



Carlo F. Centore, PE  
Principal - Structural



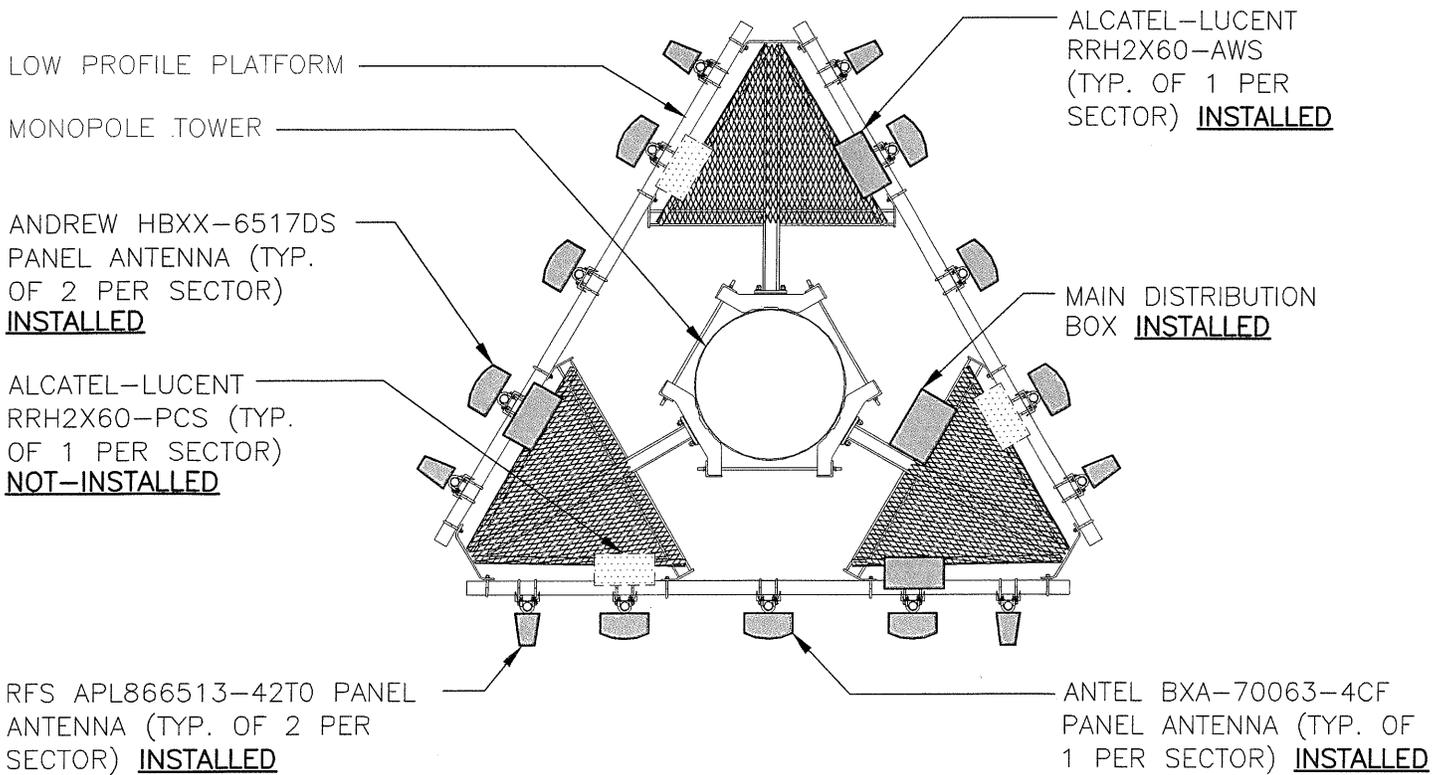

SECTOR	PANEL ANTENNA		REMOTE RADIO HEAD	
	Model	Status	Model	Status
ALPHA	APL866513-42T0	INSTALLED	N/A	N/A
	HBXX-6517DS	INSTALLED	RRH2X60-PCS	NOT-INSTALLED
	BXA-70063-4CF	INSTALLED	N/A	N/A
	HBXX-6517DS	INSTALLED	RRH2X60-AWS	INSTALLED
	APL866513-42T0	INSTALLED	N/A	N/A
BETA	APL866513-42T0	INSTALLED	N/A	N/A
	HBXX-6517DS	INSTALLED	RRH2X60-PCS	NOT-INSTALLED
	BXA-70063-4CF	INSTALLED	N/A	N/A
	HBXX-6517DS	INSTALLED	RRH2X60-AWS	INSTALLED
	APL866513-42T0	INSTALLED	N/A	N/A
GAMMA	APL866513-42T0	INSTALLED	N/A	N/A
	HBXX-6517DS	INSTALLED	RRH2X60-PCS	NOT-INSTALLED
	BXA-70063-4CF*	INSTALLED	N/A	N/A
	HBXX-6517DS	INSTALLED	RRH2X60-AWS	INSTALLED
	APL866513-42T0	INSTALLED	N/A	N/A

\* ONE (1) BXA-70063-4CF PANEL ANTENNA INSTALLED IN-LIEU OF ONE (1) BXA-70040-4CF PANEL ANTENNA.

1  
ABS-K-1

## AS-BUILT EQUIPMENT CONFIGURATION

SCALE: NOT TO SCALE

REVISIONS		
0	6/7/16	AS-BUILT

**CEN TEK** engineering  
Centered on Solutions™  
www.CentekEng.com  
(203) 488-0580  
(203) 488-8587 Fax  
43-2 North Branford Road, Branford, CT 06405

OXFORD  
338 OXFORD ROAD  
OXFORD, CT 06478

PROJECT NO: 16003.007  
DRAWN BY: T.JL  
CHECKED BY: CFC  
SCALE: AS NOTED  
DATE: 6/7/16

ABS-K-1  
DWG. 1 OF 1