



**CRISTINO ASSOCIATES
INC.**

LOIS LANE/P.O. BOX 1238
REDDING, CT 06875
(203) 938-0500

LETTER OF TRANSMITTAL

DATE: 5-15-13 | JOB # 12-1008

ATTENTION: Robert Stein, Chairman

TO: The Connecticut Siting Council
Ten Franklin Square
New Britain, CT 06051

RE: Fitch Street D&M Plan

WE ARE SENDING YOU Attached Under separate Cover Via _____ the following items:
 Shop Drawings Prints Plans Change Order Specifications Samples
 Copy Of Letter Others _____

COPIES	DATE	NO.	DESCRIPTION
21	5-15-13		Description and Errata for Fitch Street D&M Plan
21	5-15-13		Shop Drawings

THESE ARE TRANSMITTED as checked below:

- For Approval
- For Your Use
- As Requested
- For Your Review And Comment
- Approved As Submitted
- Approved As Noted
- Returned For Corrections
- Resubmit _____ Copies For Approval
- Submit _____ Copies For Distribution
- Return _____ Corrected Prints

REMARKS:

RECEIVED
MAY 16 2013

CONNECTICUT
SITING COUNCIL

COPY TO: _____


SIGNED: Cathy Horn

Third Taxing District Electric Department
Development and Management Plan
for the Construction of
Fitch Street (47R) Substation
Docket No.426
Descriptions and Errata

Control House: Size went from 40' X 25' to 30' 10" X 12"


Fencing: Height was 8' all around. This changed to 12' in some portions due to elevation conditions.

Rain Garden: A revised plan will be submitted based upon approval by the City of Norwalk just shy of the growing season.

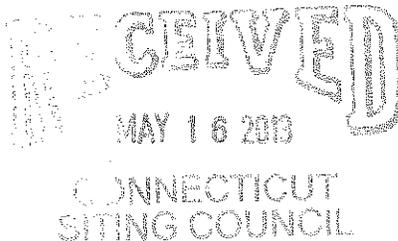

LAYOUT AND MATERIALS PLAN LEGEND:

- 25 - PROPOSED INDEX CONTOUR
- 25 - EXISTING INDEX CONTOUR
- 24 - PROPOSED INTERMEDIATE CONTOUR
- 24 - EXISTING INTERMEDIATE CONTOUR
- 34.37 - EXISTING SPOT ELEVATION
- PROPOSED CONCRETE CURB
- PROPOSED FENCE
- PROPOSED SAWCUT LINE
- EXISTING SANITARY MANHOLE
- EXISTING CATCH BASIN
- EXISTING WATER VALVE
- EXISTING WATER METER
- EXISTING HYDRANT
- EXISTING OVERHEAD ELECTRIC SERVICE
- EXISTING UTILITY POLE

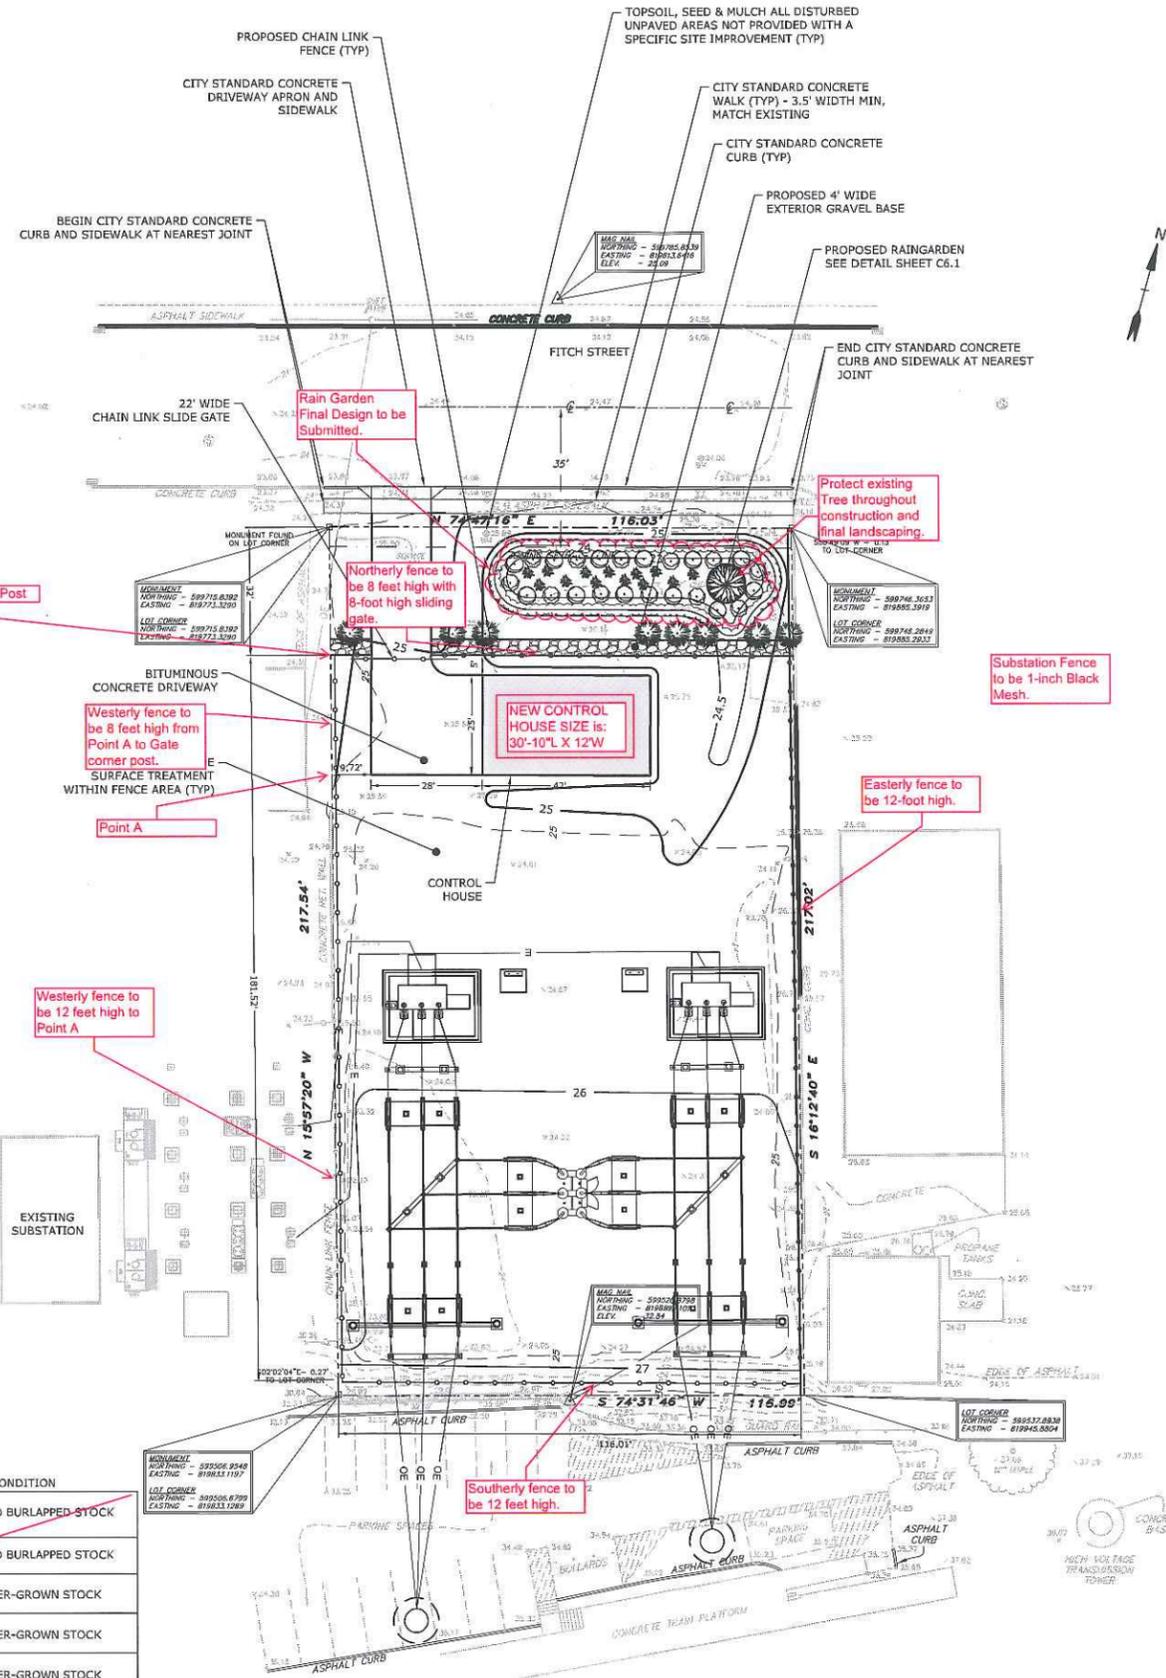


LAYOUT AND MATERIALS PLAN NOTES:

- CONTRACTOR SHALL CONTACT "CALL BEFORE YOU DIG" (1-800-922-4455) AT LEAST 48 HOURS PRIOR TO ANY EXCAVATION OPERATION.



1000 Bridgeport Avenue
Suite 320
Shelton, CT 06484
(203) 712-1100

PROGRESS SET FOR REVIEW ONLY

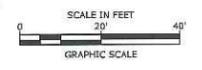

Third Taxing District

Proposed 115kv Substation

Fitch Street Norwalk, CT

December 23, 2011

Comments and notations in RED provided by Joseph A. Cristiano, P.E. for the Third Taxing District May 9, 2013

MARK	DATE	DESCRIPTION


LAYOUT AND MATERIALS PLAN

SCALE: 1" = 20'

C2.0

Dec 23, 2011 10:16am Plotted by: csl
Tighe & Bond, Inc. \\Y:\N\1895 Norwalk_TDD Siting Council App\DRAWINGS\LO-N0895-01.dwg

SYMBOL	NO.	BOTANICAL NAME	COMMON NAME	SIZE	CONDITION
	1	BETULA NEGRA	RIVER BIRCH	3" - 3 1/2"	BALLED AND BURLAPPED STOCK
	7	THUJA OCCIDENTALIS L.	ARBORVITAE	3" - 3 1/2"	BALLED AND BURLAPPED STOCK
	12	CEPHALANTHUS OCCIDENTALIS	BUTTONBUSH	30" - 36"	CONTAINER-GROWN STOCK
	12	CORNUS SERICEA	RED OSIER DOGWOOD	30" - 36"	CONTAINER-GROWN STOCK
	100	LOBELIA CARDINALIS	CARDINAL FLOWER	2" PLUG	CONTAINER-GROWN STOCK
	100	ASTER NOVAE ANGLIAE	NEW ENGLAND ASTER	2" PLUG	CONTAINER-GROWN STOCK

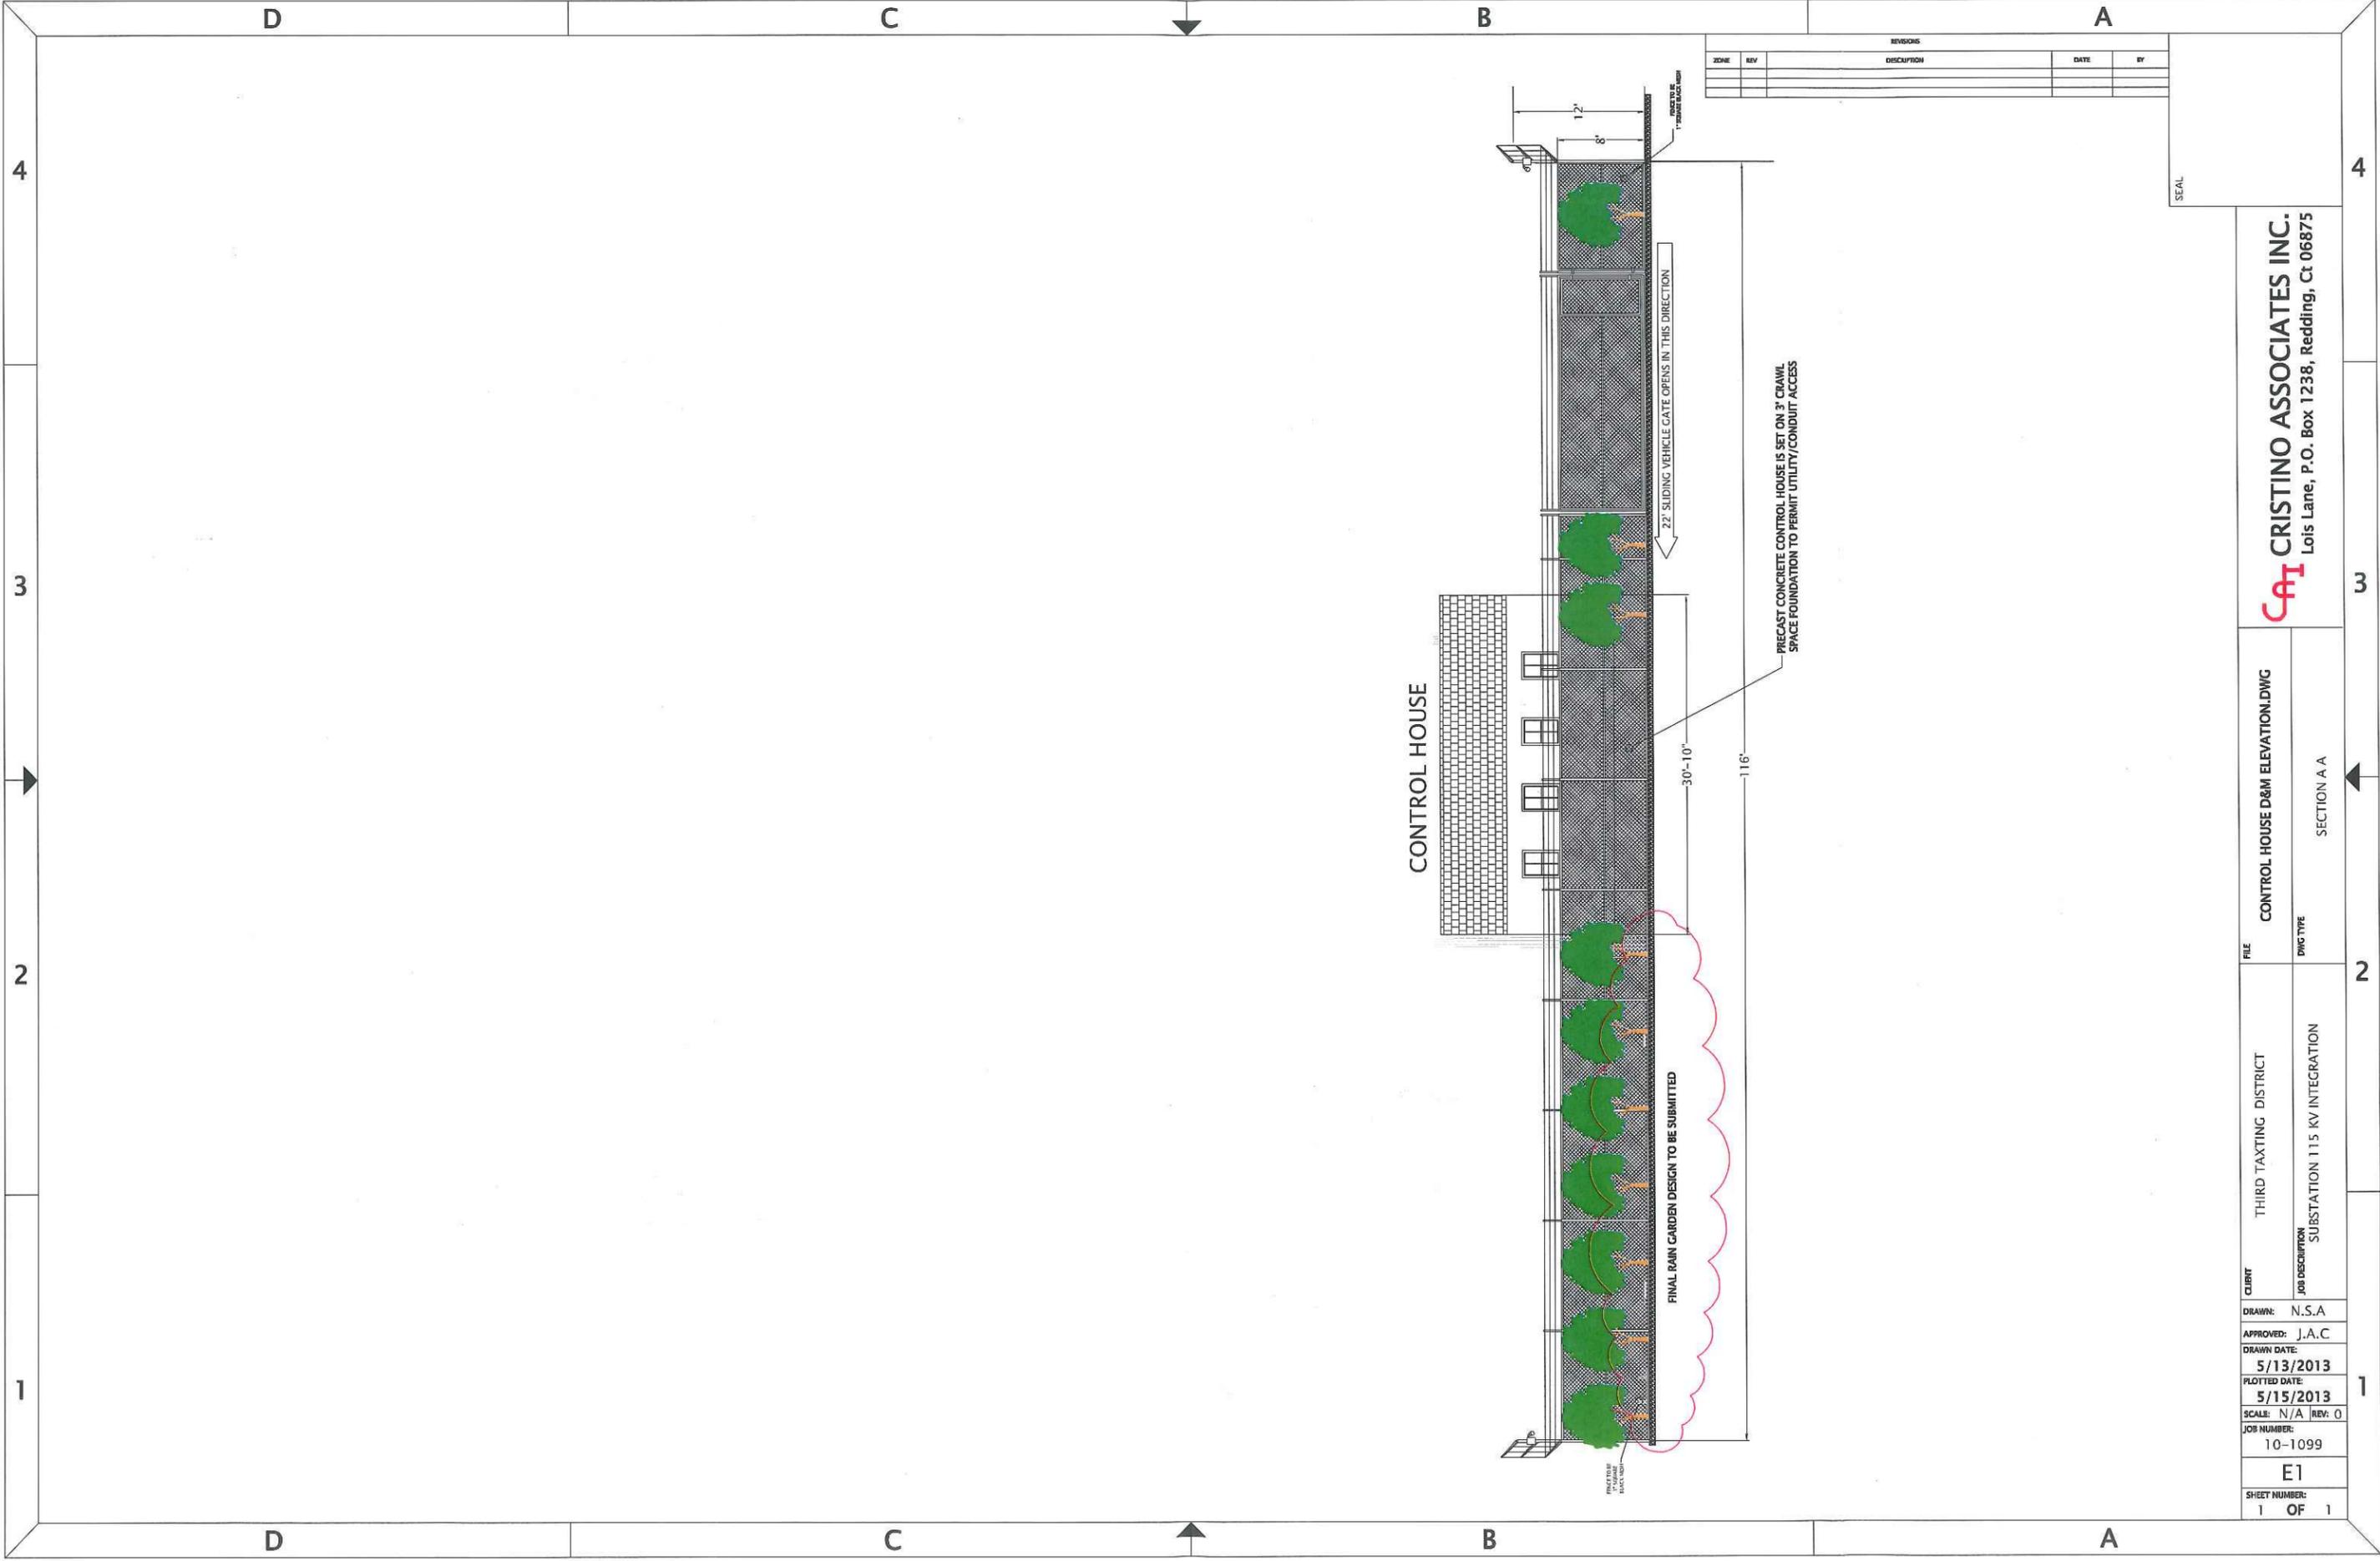

REVISIONS				
ZONE	REV	DESCRIPTION	DATE	BY

SEAL

CAI CRISTINO ASSOCIATES INC.
Lois Lane, P.O. Box 1238, Redding, Ct 06875

FILE CONTROL HOUSE D&M ELEVATION.DWG

DWG TYPE SECTION A A

CLIENT THIRD TAXING DISTRICT

JOB DESCRIPTION SUBSTATION 115 KV INTEGRATION

DRAWN: N.S.A

APPROVED: J.A.C

DRAWN DATE: 5/13/2013

PLOTTED DATE: 5/15/2013

SCALE: N/A REV: 0

JOB NUMBER: 10-1099

E1

SHEET NUMBER: 1 OF 1