
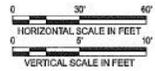


COPYRIGHT © 2006 BURNS & MCDONNELL ENGINEERING COMPANY, INC.

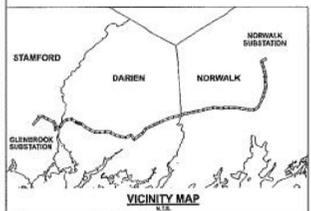

AS-BUILT

DOCKET No. 292

no.	date	revisions	by	chk




date 05/01/2006  
 designed L. PULS  
 detailed C. DEHART  
 checked R. JENSSEN

MF NO.	DATE	REVISIONS	BY	CHK	APP	APP
2	10/18/08	HANDHOLES & TMS	RK			
1	09/02/08	AS-BUILT	LJP			

NORTHEAST UTILITIES SERVICE CO.			
FOR THE CONNECTICUT LIGHT & POWER COMPANY			
TITLE GLENBROOK CABLES 115KV UNDERGROUND PROJECT TOWN OF DARIEN PLAN AND PROFILE Sta. 95+00 to 103+00			
BY RAW-EMCD	CHKD	APP	APP
DATE MAY 01, 2006	DATE	DATE	DATE
SCALE AS NOTED		D	
DWG. NO.		01230-10001 PG 012	

FOR INFORMATION ONLY

THE INFORMATION, INCLUDING ESTIMATED QUANTITIES OF WORK, SHOWN ON THESE SHEETS IS BASED ON LIMITED INVESTIGATIONS BY THE STATE AND IS IN NO WAY WARRANTED TO INDICATE THE CONDITIONS OF ACTUAL QUANTITIES OF WORK WHICH WILL BE REQUIRED.	DESIGNER/DRAFTER: <b>AMQ/MDC</b> CHECKED BY: <b>RLP</b> NOT TO SCALE	<b>STATE OF CONNECTICUT</b> DEPARTMENT OF TRANSPORTATION Filename: HW_MSH-0301-0170_UTL-01.dgn	SIGNATURE/BLOCK: PARSONS BRINCKERHOFF 500 WINDING BROOK DR. GLASTONBURY, CT 06033	PROJECT TITLE: <b>NOROTON HEIGHTS RAILROAD STATION PLATFORM REPLACEMENT</b>	TOWN: <b>DARIEN</b>	PROJECT NO. <b>301-0170</b> DRAWING NO. <b>UTL-01</b> SHEET NO. <b>07.02</b>
REV. DATE REVISION DESCRIPTION SHEET NO. Plotted Date: 5/5/2016						

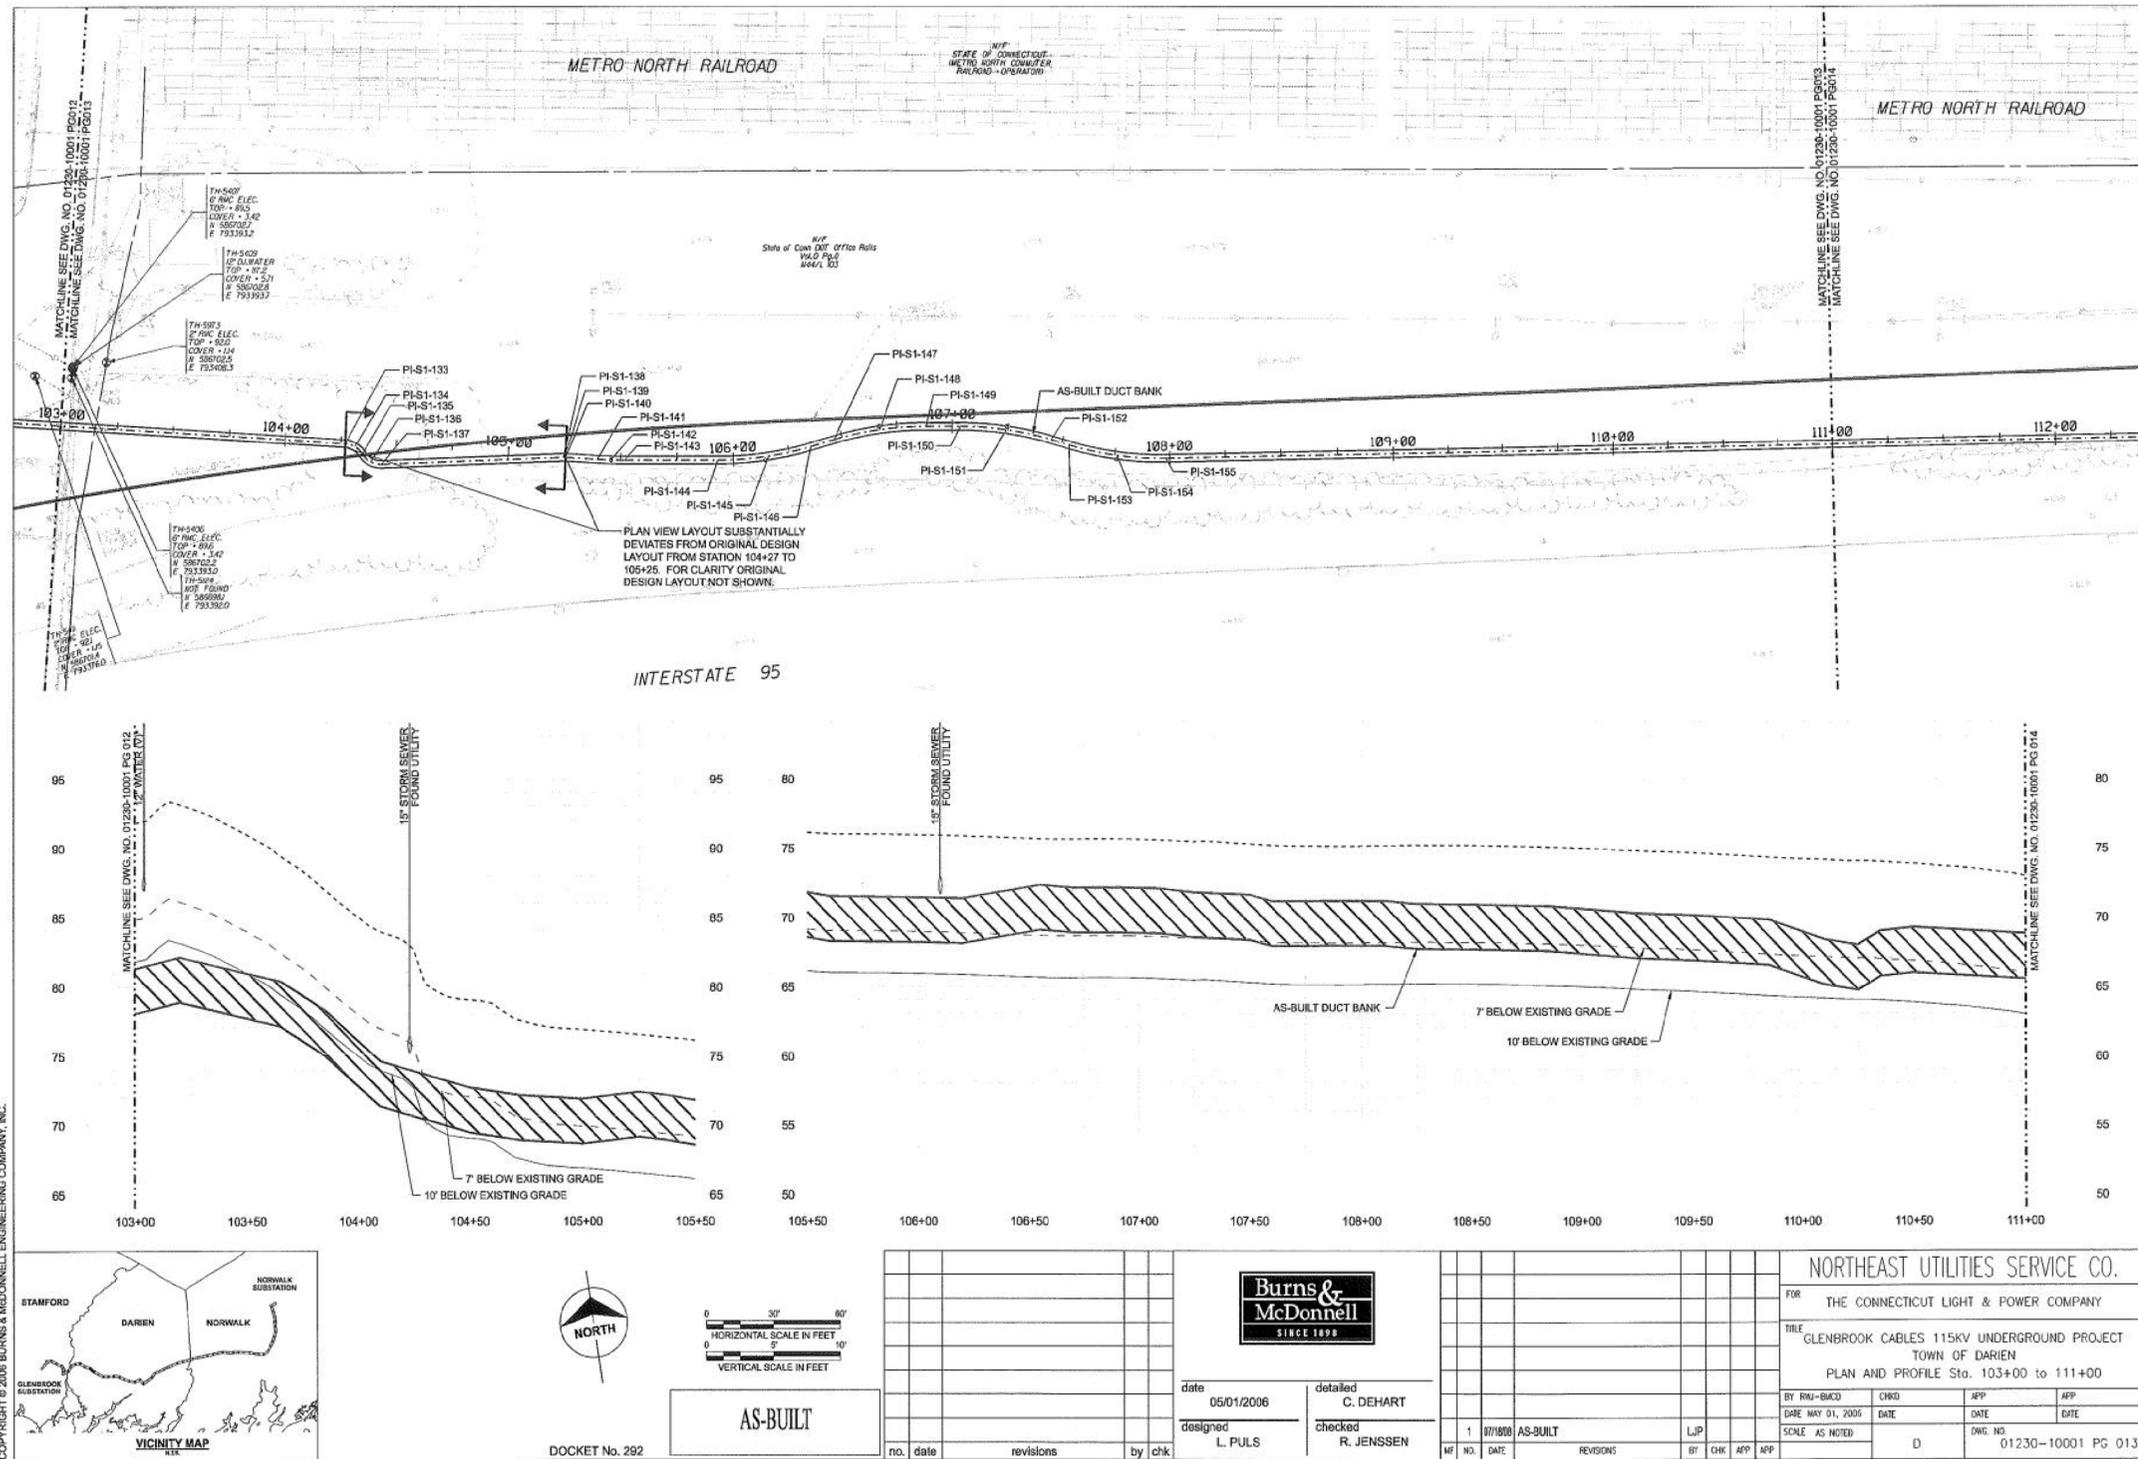

FOR INFORMATION ONLY

REV.	DATE	REVISION DESCRIPTION	SHEET NO.

THE INFORMATION, INCLUDING ESTIMATED QUANTITIES OF WORK SHOWN ON THESE SHEETS IS BASED ON LIMITED INVESTIGATIONS BY THE STATE AND IS IN NO WAY WARRANTED TO INDICATE THE CONDITIONS OF ACTUAL QUANTITIES OF WORK WHICH WILL BE REQUIRED.

DESIGNER/DRAFTER:  
**AMQ/MDC**  
CHECKED BY:  
**RLP**  
NOT TO SCALE

STATE OF CONNECTICUT  
DEPARTMENT OF TRANSPORTATION

Signature/Block:

Signature/Block:

PARSONS BRINCKERHOFF  
500 WINDING BROOK DR.  
GLASTONBURY, CT 06033

PROJECT TITLE:  
**NOROTON HEIGHTS RAILROAD STATION PLATFORM REPLACEMENT**

TOWN:  
**DARIEN**

DRAWING TITLE:  
**EVERSOURCE AS-BUILT SHEET 2**


PROJECT NO.  
**301-0170**

DRAWING NO.  
**UTL-02**



SHEET NO.  
**07.03**

Plotted Date: 5/5/2016

Filename: HW\_MSH-0301-0170\_UTL-02.dgn

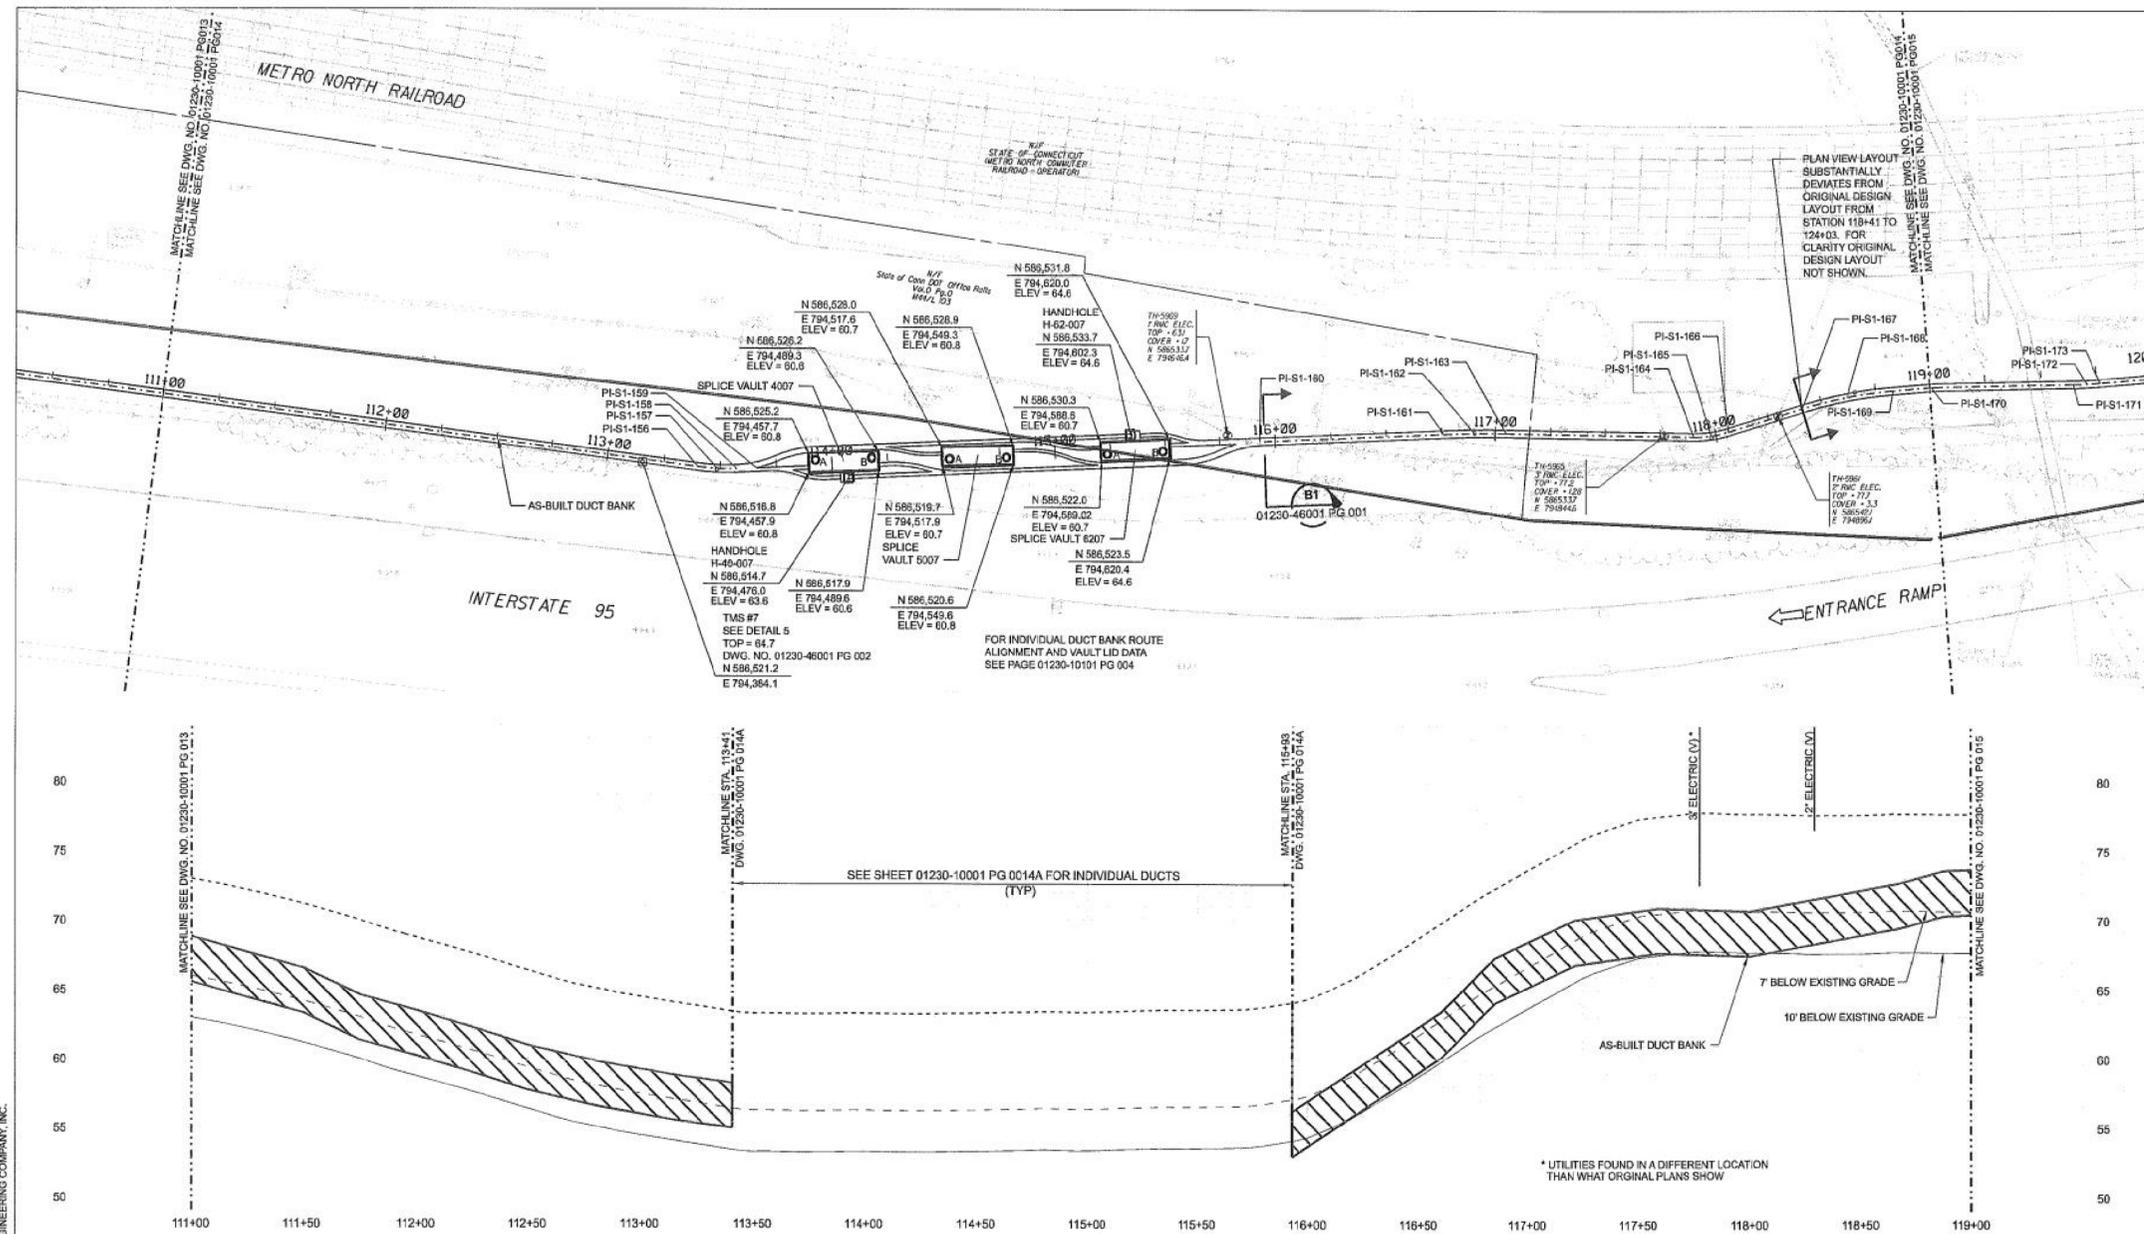

COPYRIGHT © 2006 BURNS & MCDONNELL ENGINEERING COMPANY, INC.

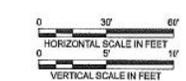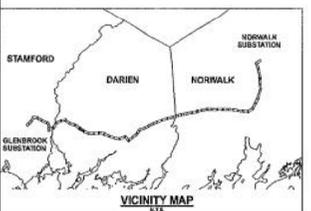

AS-BUILT

DOCKET No. 292

no.	date	revisions	by	chk







date 05/01/2006  
 designed L. PULS  
 detailed C. DEHART  
 checked R. JENSSEN

REV. NO.	DATE	REVISIONS	BY	CHK	APP	APP
2	12/04/07	REV 116+50 TO 117+70 REPAIRS	LJP			
1	07/08/07	AS-BUILT	LJP			

NORTHEAST UTILITIES SERVICE CO.					
FOR THE CONNECTICUT LIGHT & POWER COMPANY					
TITLE: GLENBROOK CABLES 115KV UNDERGROUND PROJECT TOWN OF DARIEN PLAN AND PROFILE Sta. 111+00 to 119+00					
BY: RJK-BMCD	CHKD:	APP:	DATE: MAY 01, 2006	DATE:	DATE:
SCALE: AS NOTED	DWG. NO.: 01230-10001 PG 014				

FOR INFORMATION ONLY

THE INFORMATION, INCLUDING ESTIMATED QUANTITIES OF WORK SHOWN ON THESE SHEETS IS BASED ON LIMITED INVESTIGATIONS BY THE STATE AND IS IN NO WAY WARRANTED TO INDICATE THE CONDITIONS OF ACTUAL QUANTITIES OF WORK WHICH WILL BE REQUIRED.	DESIGNER/DRAFTER: <b>AMQ/MDC</b> CHECKED BY: <b>RLP</b> NOT TO SCALE	<b>STATE OF CONNECTICUT</b> DEPARTMENT OF TRANSPORTATION Filename: HW_MSH-0301-0170_UTL-03.dgn	SIGNATURE/BLOCK: PARSONS BRINCKERHOFF 500 WINDING BROOK DR. GLASTONBURY, CT 06033	PROJECT TITLE: <b>NOROTON HEIGHTS RAILROAD STATION PLATFORM REPLACEMENT</b>	TOWN: <b>DARIEN</b>	PROJECT NO.: <b>301-0170</b> DRAWING NO.: <b>UTL-03</b> SHEET NO.: <b>07.04</b>
REV. DATE REVISION DESCRIPTION SHEET NO. Plotted Date: 5/5/2016	Docket No. 292					

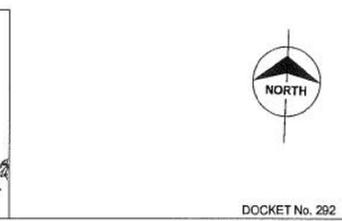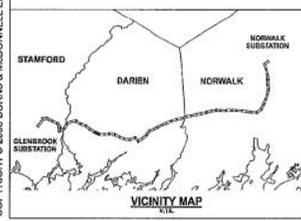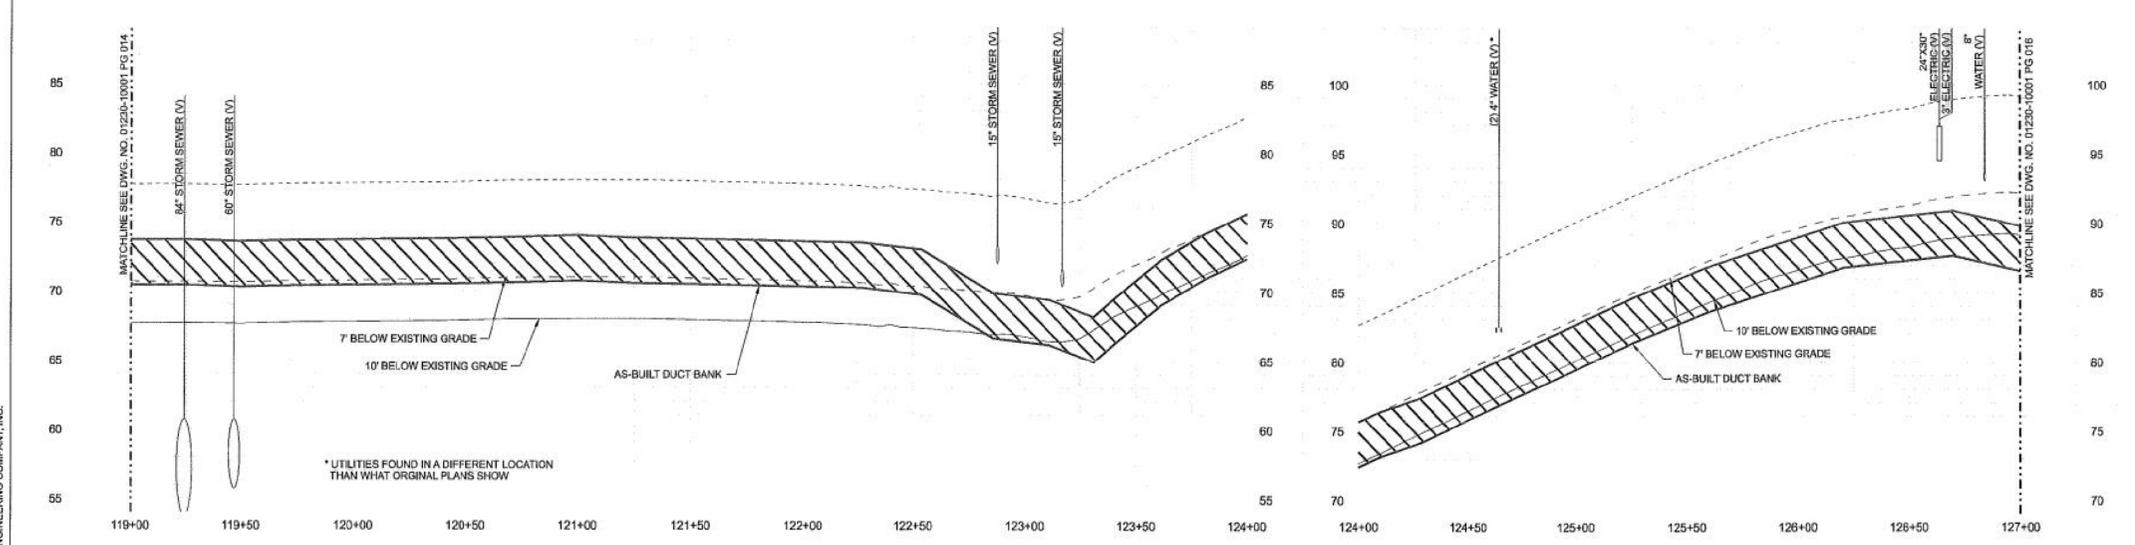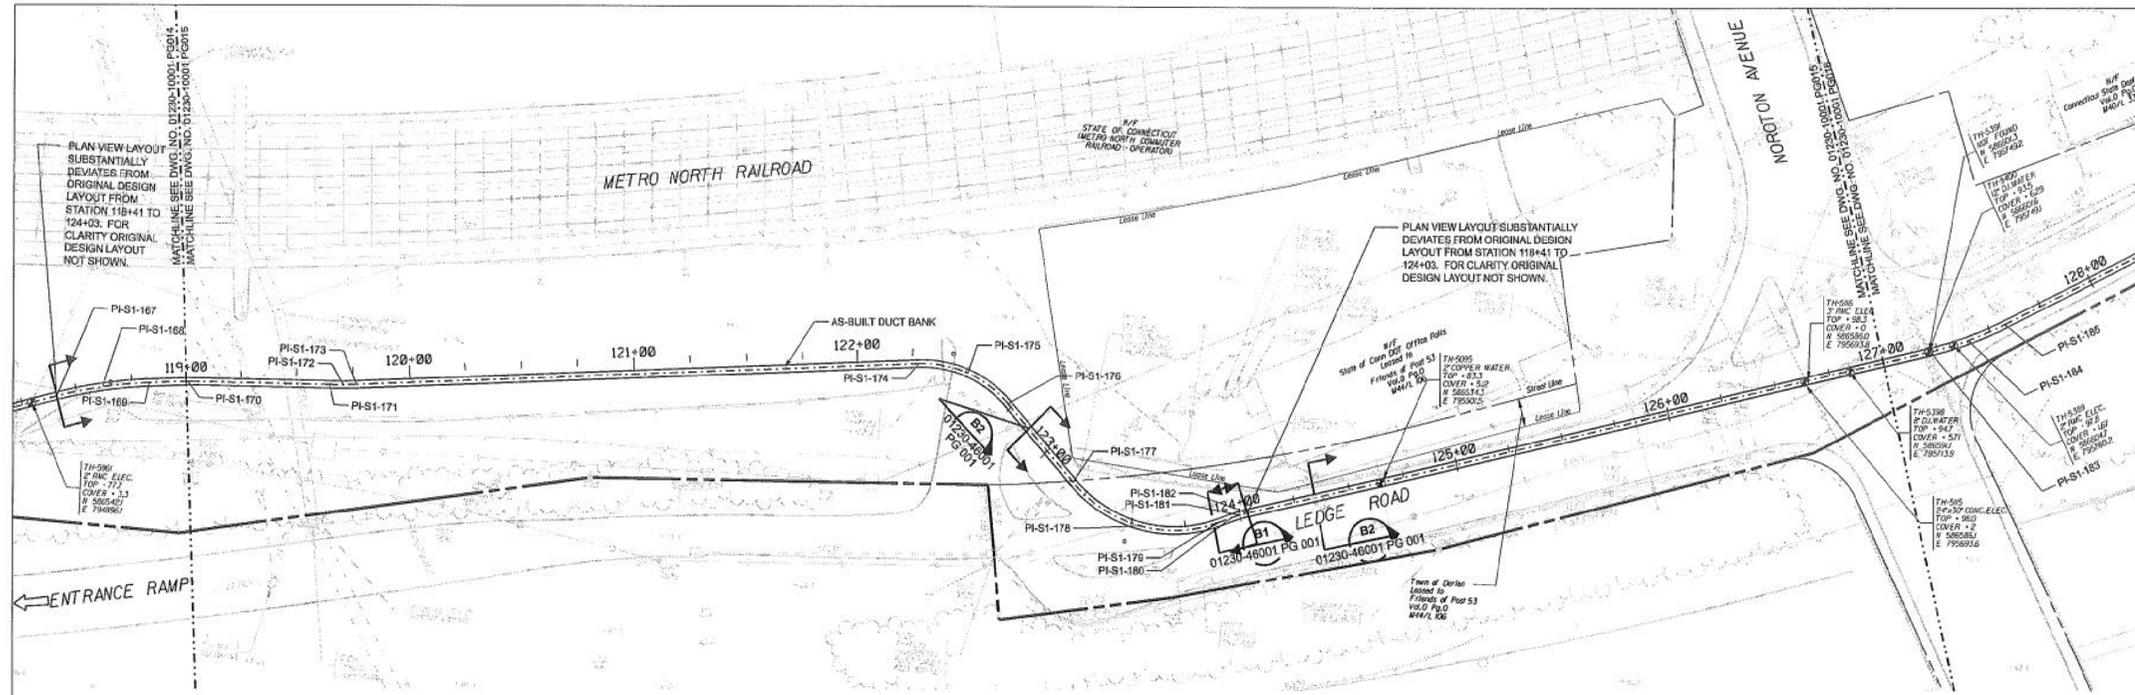

no.	date	revisions	by	chk

**Burns & McDonnell**  
SINCE 1938

date 05/01/2006 detailed C. DEHART  
designed L. PULS checked R. JENSSEN

NORTHEAST UTILITIES SERVICE CO.			
FOR THE CONNECTICUT LIGHT & POWER COMPANY			
TITLE GLENBROOK CABLES 115KV UNDERGROUND PROJECT			
TOWN OF DARIEN			
PLAN AND PROFILE Sta. 119+00 to 127+00			
BY RWJ-DMC	CHKD	APP	APP
DATE MAY 01, 2006	DATE	DATE	DATE
SCALE AS NOTED	D	DWG. NO. 01230-10001 PG 015	

FOR INFORMATION ONLY


REV.	DATE	REVISION DESCRIPTION	SHEET NO.	Plotted Date: 5/5/2016	DESIGNER/DRAFTER: <b>AMQ/MDC</b> CHECKED BY: <b>RLP</b> NOT TO SCALE	<b>STATE OF CONNECTICUT</b> DEPARTMENT OF TRANSPORTATION Filename: HW_MSH-0301-0170_UTL-04.dgn	<b>Burns &amp; McDonnell</b> SINCE 1938 date 05/01/2006 detailed C. DEHART designed L. PULS checked R. JENSSEN	<b>PARSONS BRINCKERHOFF</b> 500 WINDING BROOK DR. GLASTONBURY, CT 06033 PROJECT TITLE: <b>NOROTON HEIGHTS RAILROAD STATION PLATFORM REPLACEMENT</b>	TOWN: <b>DARIEN</b> DRAWING TITLE: <b>EVERSOURCE AS-BUILT SHEET 4</b>	PROJECT NO. <b>301-0170</b> DRAWING NO. <b>UTL-04</b> SHEET NO. <b>07.05</b>
------	------	----------------------	-----------	------------------------	--	--	---	--	--	--



Northeast Utilities  
Overhead Transmission Standards




Attachment 1

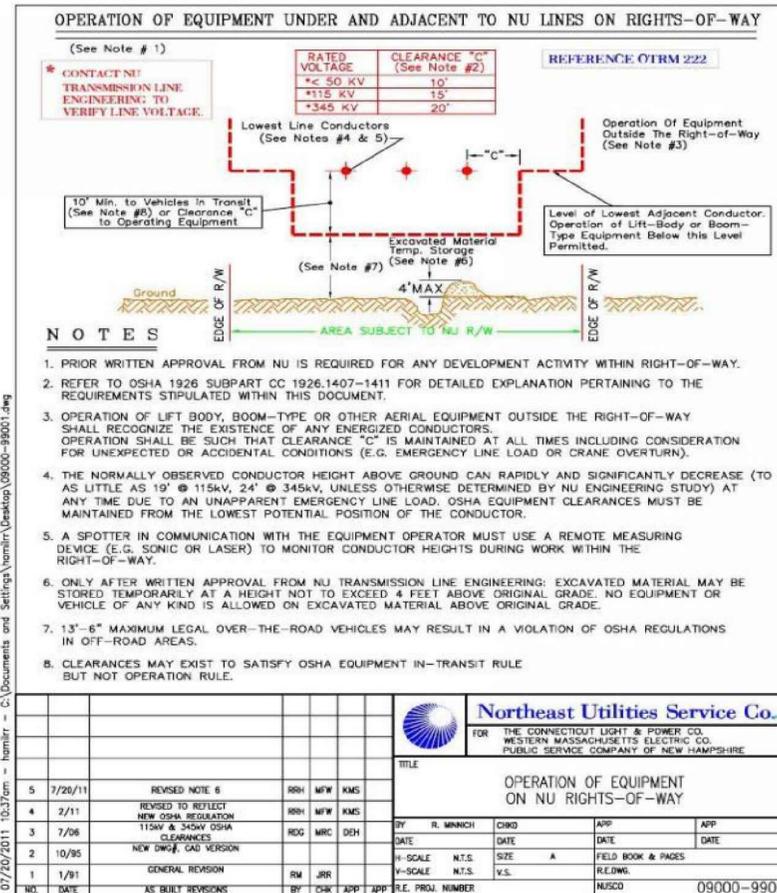

Operation of Equipment on NU Rights-of-Way			
Northeast Utilities	Construction	OTRM 222	Rev.3
Approved by: KMS (CT/MA), JJJ (NH)		Page 4 of 4	01/24/2012

FOR INFORMATION ONLY

DESIGNER/DRAFTER: <b>AMQ/MDC</b>	<p>STATE OF CONNECTICUT DEPARTMENT OF TRANSPORTATION</p>	<p>PARSONS BRINCKERHOFF 500 WINDING BROOK DR. GLASTONBURY, CT 06033</p>	<p>PROJECT TITLE: <b>NOROTON HEIGHTS RAILROAD STATION PLATFORM REPLACEMENT</b></p>	<p>TOWN: <b>DARIEN</b></p>	<p>PROJECT NO. <b>301-0170</b></p>
CHECKED BY: <b>RLP</b>					
NOT TO SCALE	<p>Filename: HW_MSH-0301-0170_UTL-05.dgn</p>	<p>PROFESSIONAL ENGINEER</p>	<p>OPERATION OF EQUIPMENT ON NU RIGHTS-OF-WAY</p>	<p>SHEET NO. <b>07.06</b></p>	<p>THE INFORMATION, INCLUDING ESTIMATED QUANTITIES OF WORK SHOWN ON THESE SHEETS IS BASED ON LIMITED INVESTIGATIONS BY THE STATE AND IS IN NO WAY WARRANTED TO INDICATE THE CONDITIONS OF ACTUAL QUANTITIES OF WORK WHICH WILL BE REQUIRED.</p>
REV. DATE REVISION DESCRIPTION SHEET NO. Plotted Date: 5/5/2016					

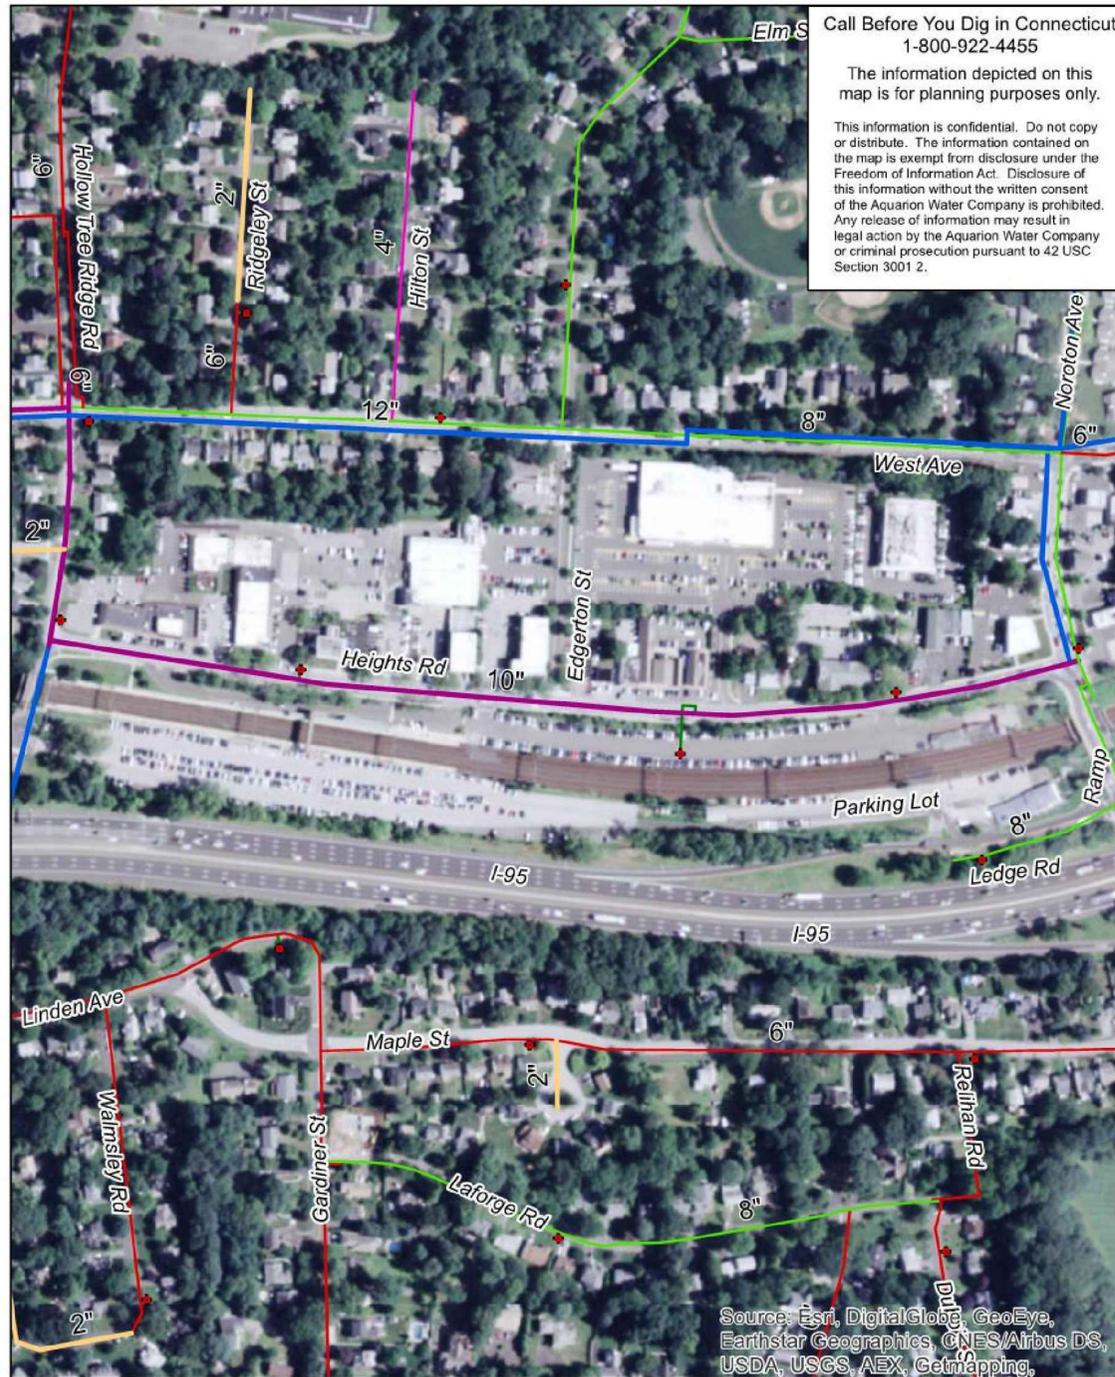

Call Before You Dig in Connecticut  
1-800-922-4455

The information depicted on this map is for planning purposes only.

This information is confidential. Do not copy or distribute. The information contained on the map is exempt from disclosure under the Freedom of Information Act. Disclosure of this information without the written consent of the Aquarion Water Company is prohibited. Any release of information may result in legal action by the Aquarion Water Company or criminal prosecution pursuant to 42 USC Section 3001.2.



NOROTON HEIGHTS RAILROAD STATION  
DARIEN, CT

0 200 400  
Feet



FOR INFORMATION ONLY

THE INFORMATION, INCLUDING ESTIMATED QUANTITIES OF WORK, SHOWN ON THESE SHEETS IS BASED ON LIMITED INVESTIGATIONS BY THE STATE AND IS IN NO WAY WARRANTED TO INDICATE THE CONDITIONS OF ACTUAL QUANTITIES OF WORK WHICH WILL BE REQUIRED.		DESIGNER/DRAFTER: <b>AMQ/MDC</b> CHECKED BY: <b>RLP</b> NOT TO SCALE	<b>STATE OF CONNECTICUT</b> DEPARTMENT OF TRANSPORTATION Filename: HW_MSH-0301-0170_UTL-06.dgn	SIGNATURE/BLOCK:  PARSONS BRINCKERHOFF 500 WINDING BROOK DR. GLASTONBURY, CT 06033	PROJECT TITLE: <b>NOROTON HEIGHTS RAILROAD STATION PLATFORM REPLACEMENT</b>	TOWN: <b>DARIEN</b> DRAWING TITLE: <b>AQUARION WATER</b>	PROJECT NO. <b>301-0170</b> DRAWING NO. <b>UTL-06</b> SHEET NO. <b>07.07</b>
REV.	DATE	REVISION DESCRIPTION	SHEET NO.	Plotted Date: 5/5/2016			